# FE210

Diagrams 1000-3 & 1220-2

NOAA FORM 76-35A

U.S. DEPARTMENT OF COMMERCE
NATIONAL OCEANIC AND ATMOSPHERIC ADMINISTRATION
NATIONAL OCEAN SURVEY

### DESCRIPTIVE REPORT

(HYDROGRAPHIC)

Type of Survey Field Examination

Field No.

Office No. FE-210 (1966)

LOCALITY

State Maryland

General Locality Pocomoke River

Locality Pocomoke City to Snow Hill

1965

CHIEF OF PARTY
W.E. Ward

LIBRARY & ARCHIVES

DATE August 31, 1971

☆ U.S. GOV. PRINTING OFFICE: 1976-669-441

NOTE: A new system for registering Field Examinations (FE's) was established in 1980. All FE's are now consecutively numbered as shown hereon. The date shown in the new format is the actual date of survey. This material was previously registered as;

FE No.1 1971

予田210

# FENO.1 1971

Diag. Cht. Nos. 1000-3 & 1220-2.

FORM C&GS-504

U.S. DEPARTMENT OF COMMERCE ENVIRONMENTAL SCIENCE SERVICES ADMINISTRATION COAST AND GEODETIC SURVEY

## DESCRIPTIVE REPORT

Type of Survey

Field No. Office No. F.E.No.1-1971

#### LOCALITY

State Maryland

General locality Pocomoke River

Locality Pocomoke City to Snow Hill

19 65

CHIEF OF PARTY

W. E. WARD

LIBRARY & ARCHIVES

DATE 8-31-71

USCOMM-DC 37022-P66

Registry number: FE-1-71

Locality: Pocomoke River, Maryland, Pocomoke City

to Snow Hill

Date of field work: 1965

Project number: Special

Party: Wheatley E. Ward

Thomas Orlowski Patrick Dempsey

NOTE: It has been established by members of the Marine Chart Division, National Ocean Survey, on August 27, 1971, that this survey (FE-1-71) need not be verified or reviewed, is it necessary to ink the penciled lines. For all practical purposes, FE-1-71 can be considered

a finalized survey.

Earl W. Rayfield

Chief, Hydrographic Data

Section

Pencilled smooth sheet soundings, are very weak and should be inked during cartographic training. Plot should be verified but not reviewed. Use for cartographic training assignment, Make film positive on .oo4 mylar after verification and insert in descriptive report. Cut to strip.

As the Venitier of this field exit, I took no action on naving a film positive made. I left this to be done at any time in the future.

FORM C&GS-946 (REV. 11-65) (PRESC. BY HYDROG RAPHIC MANUAL 20-2, 6-94, 7-13)

# U.S. DEPARTMENT OF COMMERCE ENVIRONMENTAL SCIENCE SERVICES ADMINISTRATION COAST AND GEODETIC SURVEY NAUTICAL CHART DIVISION

## HYDROGRAPHIC SURVEY STATISTICS HYDROGRAPHIC SURVEY NO. F.E.No. 1-1971

RECORDS ACCOMPANYING SURVEY: To be completed when survey is registered.

RECORD DESCRIPTION		AMOUNT			AMOUNT			
SMOOTH SHEET					BOATS	HEETS		1
DESCRIPTIVE R	EPORT		1		OVERL	AYS	7	
DESCRIPTION	DEPTH RECORDS	HORIZ.		PRINT	TOUTS	TAPE ROLLS	PUNCHED CARDS	ABSTRACTS/ SOURCE DOCUMENTS
ENVELOPES	1							1
CAHIERS								
VOLUMES	2							
BOXES								

T-SHEET PRINTS (List)

3-Manuscript Copies

SPECIAL REPORTS (List)

#### OFFICE PROCESSING ACTIVITIES

The following statistics will be submitted with the cartographer's report on the survey

	AMOUNTS						
PROCESSING ACTIVITY	PRE- VERIFICATION	VERIFICATION	REVIE	W	TQTALS		
POSITIONS ON SHEET					274		
POSITIONS CHECKED		274					
POSITIONS REVISED		2					
DEPTH SOUNDINGS REVISED		14					
DEPTH SOUNDINGS ERRONEOUSLY SPACED		30					
SIGNALS ERRONEOUSLY PLOTTED OR TRANSFERRED		0.					
		TIME (MA	NHOURS)				
TOPOGRAPHIC DETAILS		12					
JUNCTIONS		0	1				
VERIFICATION OF SOUNDINGS FROM GRAPHIC RECORDS		18					
SPECIAL ADJUSTMENTS		26					
ALL OTHER WORK		116					
TOTALS		172					
PRE-VERIFICATION BY		BEGINNINGDATE		ENDING	DATE		
Bruce Alan Olmstead REVIEW BY	✓ DR €	BEGINNING DATE  O4 Augus  BEGINNING DATE	+ 72	ENDING SENDING	September		

#### U.S. DEPARTMENT OF COMMERCE ESSA COAST AND GEODETIC SURVEY

USCOMM-DC 36272-P65

### VERIFIER'S REPORT


#### HYDROGRAPHIC SURVEY, # F.E.No. 1-1971


INSTRUCTIONS - This form serves to identify items of a check list in verification together with items which are separately reported to the Reviewer. The form is not to be forwarded to the Reviewer. A report, which is prepared for the Reviewer, should identify items by number and letter and will be filed in the Descriptive Report until the survey is reviewed.

- CL Check List Items: should be checked as having been completed during the verification processes.
- R Report Item: This column refers to those items reported to the reviewer and is used to indicate the items discussed.

Part I - DESCRIPTIVE REPORT	CL	R	Part III - JUNCTIONS (Continued)	CL	R
Note: The verifier should first read the Descriptive Report for general information and problems.	,		<ol> <li>Junctions with contemporary surveys were satisfactory except as follows:</li> </ol>	C-1.40	
1. The Descriptive Report was consulted, paragraphs checked if found satisfactory, and notations were made in soft black pencil regarding action taken.  Remarks Required: None	/		Remarks Required: Consider conditions after adjustments have been made; note adjustments made. Make special notes of Butt junctions and areas which are SUPERSEDED.		
2. Soundings originating with the survey and mentioned in the Descriptive Report have been verified and checked in soft black pencil, including latitude and longitude, together with position identification.  Remarks Required: None  3. All reference to survey sheets mentioned in	/		Part IV - VOLUMES  11. All items affecting the plotting of the survey which are entered in the remarks columns of the sounding records were noted and check marked. In all cases appropriate action was taken and exceptions noted in the volumes.  Remarks Required: None	/	
the Descriptive Report should include registry number and year.	/		12. Condition of sounding records was satisfactory		
Remarks Required: None	V		except as follows:		
Part II - SHORELINE AND SIGNALS  4. Source of shoreline signals Remarks Required: List all surveys	(19	42)	Remarks Required: Mention deficiencies in completeness of notes or actions for the follow-ing:		
4. Source of shoreline signals Remarks Required: List all surveys 7-8/38  a. Give earliest and latest dates of photographs	(19	42)	(a) rocks (b) line turns	1	
b. Field inspection date 19412 on c. Field Edit date 1942, 1943 heets	1		(c) position values of beginning and ending of lines	_	
d. Reviewed- <u>Unreviewed</u> 5. The transfer of contemporary topographic	V .		(d) bar check or velocity correctors at tempt (e) time recording	/	
information was carefully examined and reconciled with the hydrography.	,		(f) notes or markings on fathograms (g) was reduction of soundings accurately	/	
Remarks Required: Discuss remaining differences.	/		done?	1	
<ol> <li>The plotting of all triangulation stations, topo- graphic stations and hydrographic signals has been checked and noted in processing stamp No. 42 on the smooth sheet.</li> </ol>	. /		(i) were peaks at uneven intervals missed?  (j) were stamps completed? NO Stamps	/	
Remarks Required: None	/		(k) references to adjacent features		
7. Objects on which signals are located and which fall outside of the high-water line have been described on the sheet.  Remarks Required: List those signals still unidentified.	/		Part V - PROTRACTING  13. All positions verified instrumentally were check marked in color in the sounding records, and verifier initialed the processing stamp.  Remarks Required: None	/	
Part III - JUNCTIONS			Positions not established by 3-point fix.		
Note: Make a cursory comparison preliminary to inking soundings in area of overlap.			14. The protracting and plotting of all unsatis- factory crossings were verified.	1	
8. All junctions of contemporary or overlapping sheets were transferred in colored ink and overlapping curves were made identical.			Remarks Required: None	<b>\</b>	
9. The notation in slanted lettering "JOINS H (19)" was added in colored ink for all verified contemporary adjoining or overlapping sheets. Those not verified are shown in pencil.			15. All detached positions locating critical soundings, rocks, buoys, breakers, obstructions, kelp, etc., were verified and the position numbers are legible.	/	
Remark's Required: None			Remarks Required: None		

Part V - PROTRACTING (Continued) 16. The protracting was satisfactory except as	CL	R	Patt VIII - AIDS TO NAVIGATION  26. All fixed aids located together with those on	CL	R
follows: Refer to Number 13  Remarks Required: Refers to protracting in general except for specific faults repeated often, or faults in control information, which required considerable replotting or adjustments.	×		the contemporary topographic sheets, have been shown on the survey. None  Remarks Required: Conflicts of any nature listed.	100 A	3
17. The protractor has been checked within the last three months. See above Remarks Required: Date of check, type of protractor and number.			27. All floating aids listed in the Descriptive Report should be verified and checked in soft black pencil, including latitude and longitude and position identification.  Remarks Required: None		
Part VI - SOUNDINGS  18. All soundings are clear and legible, and critical soundings are a little larger than adjacent soundings.  Remarks Required: None	/	1	Part IX - BOAT SHEET  28. The boat sheet was constantly compared with the smooth sheet with reference to notes, position of sounding lines and supplemental information.	1	1287
19. Sounding line crossings were satisfactory except as follows:  Remarks Required: Discuss adjustments.	1		Remarks Required: None  29. Heights of rocks awash were correctly re-		
20. The spacing of soundings as recorded in the records was closely followed;  Remarks Required: None	1		duced and compared with topographic information.  Remarks Required: Note excessive conflicts with topographic information.		
			Part X - GENERAL		
21. The scanning, reduction, spacing, plotting of questionable soundings have been verified.  Remarks Required: None	/		30. All information on the sheet is shown in accordance with figures 82 and 83 in the Hydrographic Manual (Pub. 20-2).	/	
22. The smooth plotting of soundings was satisfactory except as follows:			Remarks Required: None	1245. 13	1
Remarks Required: - Refer to legibility, errors in spacing, and errors in numbers - but not to errors in scanning.	/		31. Unnecessary pencil notes have been removed from the sheet.  Remarks Required: None	/	
Part VII - CURVES  23. The depth curves have been inspected before inking.  Remarks Required: By whom was the penciled curves inspected. George Meyers Done and	1		32. Degree, minute values and symbols have been checked; also electronic distance arcs have been properly identified and checked on the smooth sheet.	1	
24. The low-water line and delineation of shoal areas have been properly shown in accordance with the following:	/	4	Remarks Required: - None		
a. From T-Sheet in dotted black lines b. From soundings in orange c. Approximate position of sketched curve is	1		33. The bottom characteristics are adequately shown. None  Remarks Required: None		
dashed oránge	1	4			
d. Approximate position of shoal area not sounded in black dashed	1		Part XI - NOTES TO THE REVIEWER	200	
Remarks Required: None	a de san	1.05	34. Unresolved discrepancies and questionable soundings.		
25. Depth curves were satisfactory except as follows:  (This statement should not refer to the manner in which the curves were drawn).  Remarks Required: Indicate areas where curves could not be drawn completely because	e		35. Notation of discrepancies with photogrammetric survey inserted in report of unreviewed photogrammetric survey or on copy.	d	
of lack of soundings. For some inshore areas a general statement is sufficient.			36. Supplemental information.		
Pruce Alan Olmuteo	d		Date 15 Sept.		6272 Dec
FORM C&GS-946A (11-65)			USCON	MM-DC 3	6272-P65

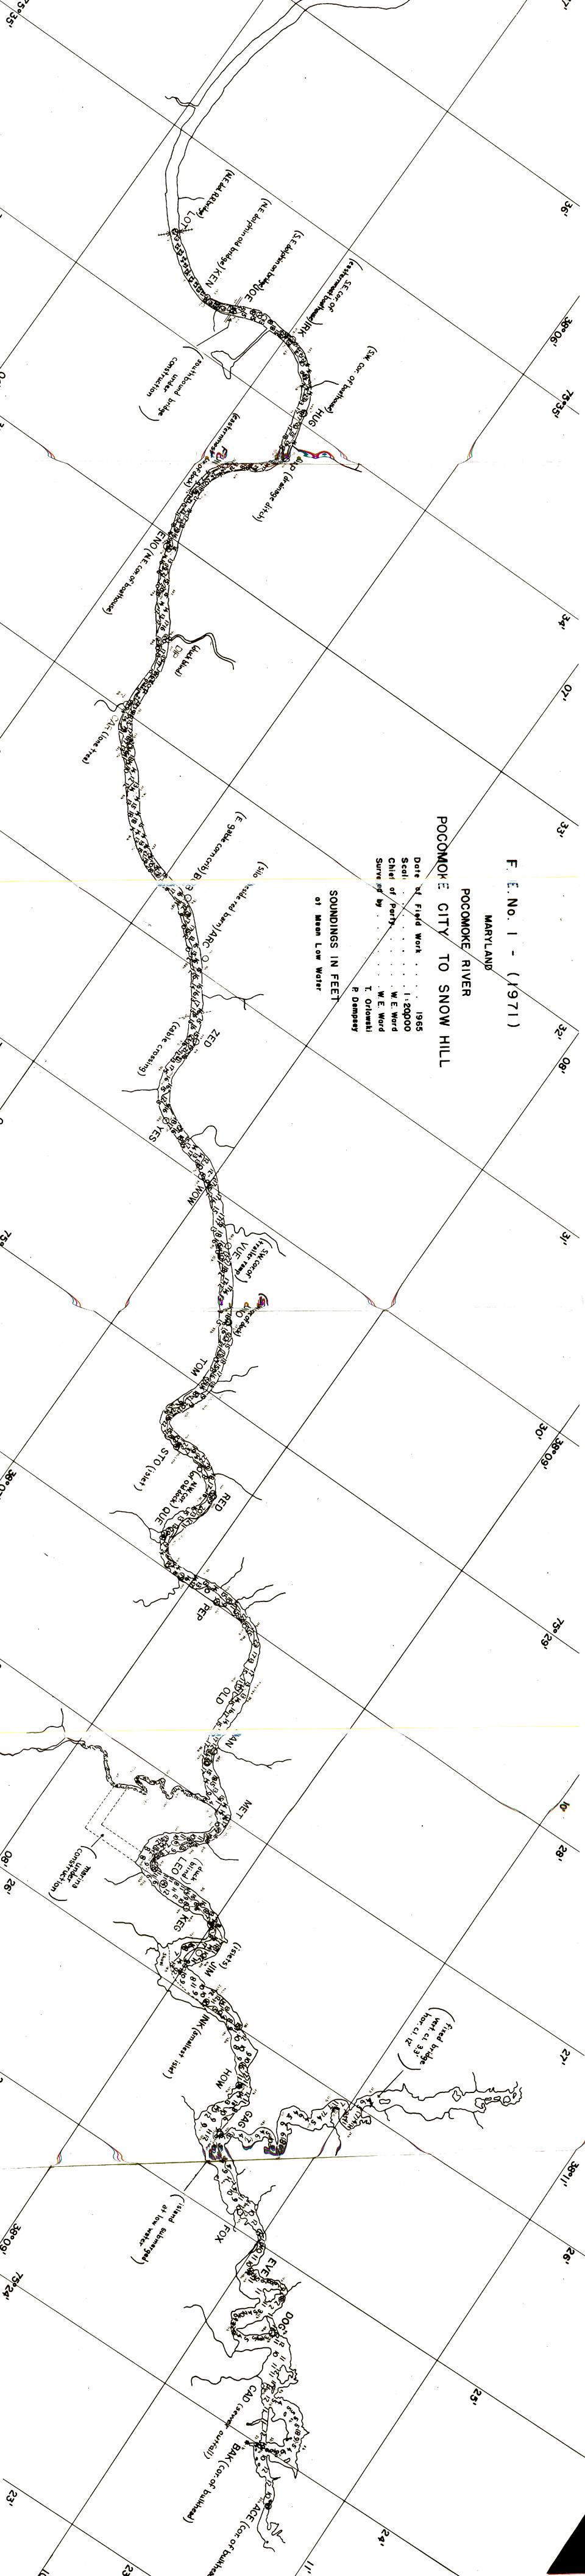

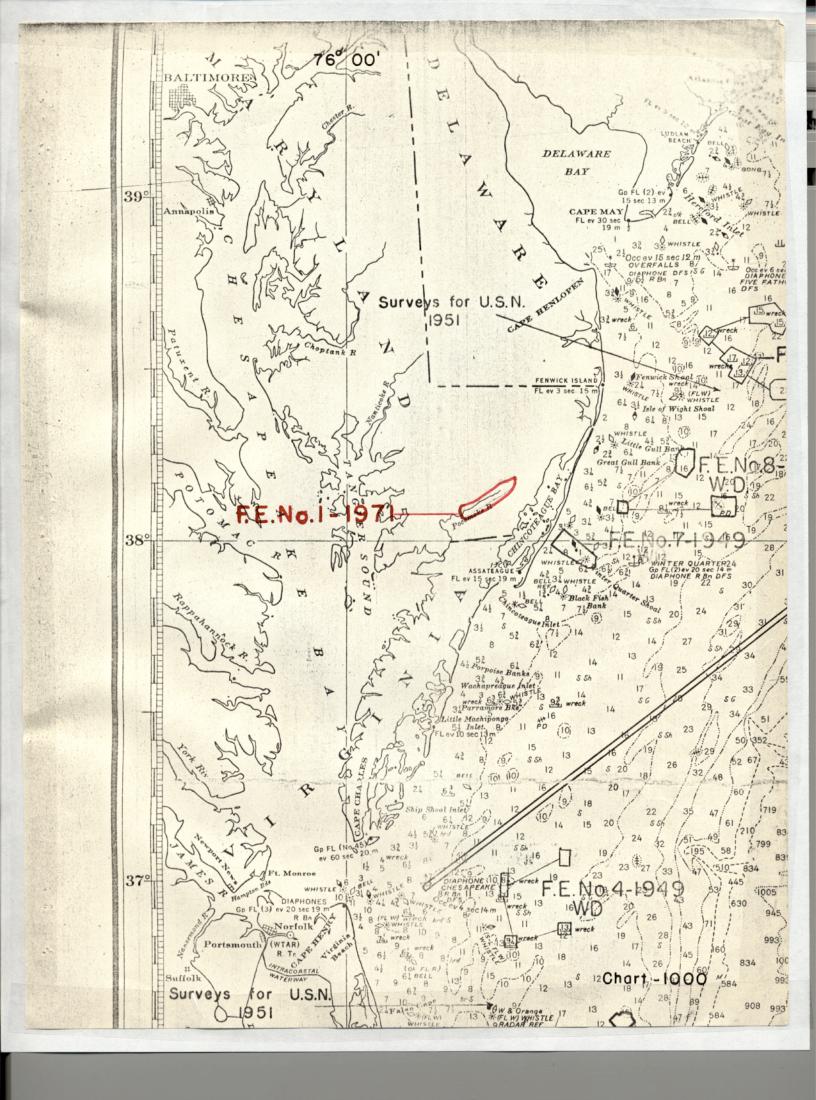

#### NAUTICAL CHART DIVISION

#### RECORD OF APPLICATION TO CHARTS

FILE WITH DESCRIPTIVE REPORT OF SURVEY NO. F.E.No. 1-1971

#### **INSTRUCTIONS**

A basic hydrographic or topographic survey supersedes all information of like nature on the uncorrected chart.

1. Letter all information.

2. In "Remarks" column cross out words that do not apply.

CHART	DATE	CARTOGRAPHER	REMARKS			
1224 2-11-72 Candleton & Buse		Carrollton & Russ	Part Before After Verification Review Inspection Signed Via			
		The state of the s	Drawing No.			
			Full Part Before After Verification Review Inspection Signed Via			
		·	Drawing No.			
			Full Part Before After Verification Review Inspection Signed Via			
	·		Drawing No.			
			Full Part Before After Verification Review Inspection Signed Via			
			Drawing No.			
			Full Part Before After Verification Review Inspection Signed Via			
			Drawing No.			
			Full Part Before After Verification Review Inspection Signed Via			
			Drawing No.			
			Full Part Before After Verification Review Inspection Signed Via			
			Drawing No.			
			Full Part Before After Verification Review Inspection Signed Via Drawing No.			
:	-					
			Full Part Before After Verification Review Inspection Signed Via Drawing No.			
		:				
			Full Part Before After Verification Review Inspection Signed Via Drawing No.			
	<del> </del>		Diawing No.			